


# IZVEDENO STANJE

## TLOCRT PRIZEMLJA

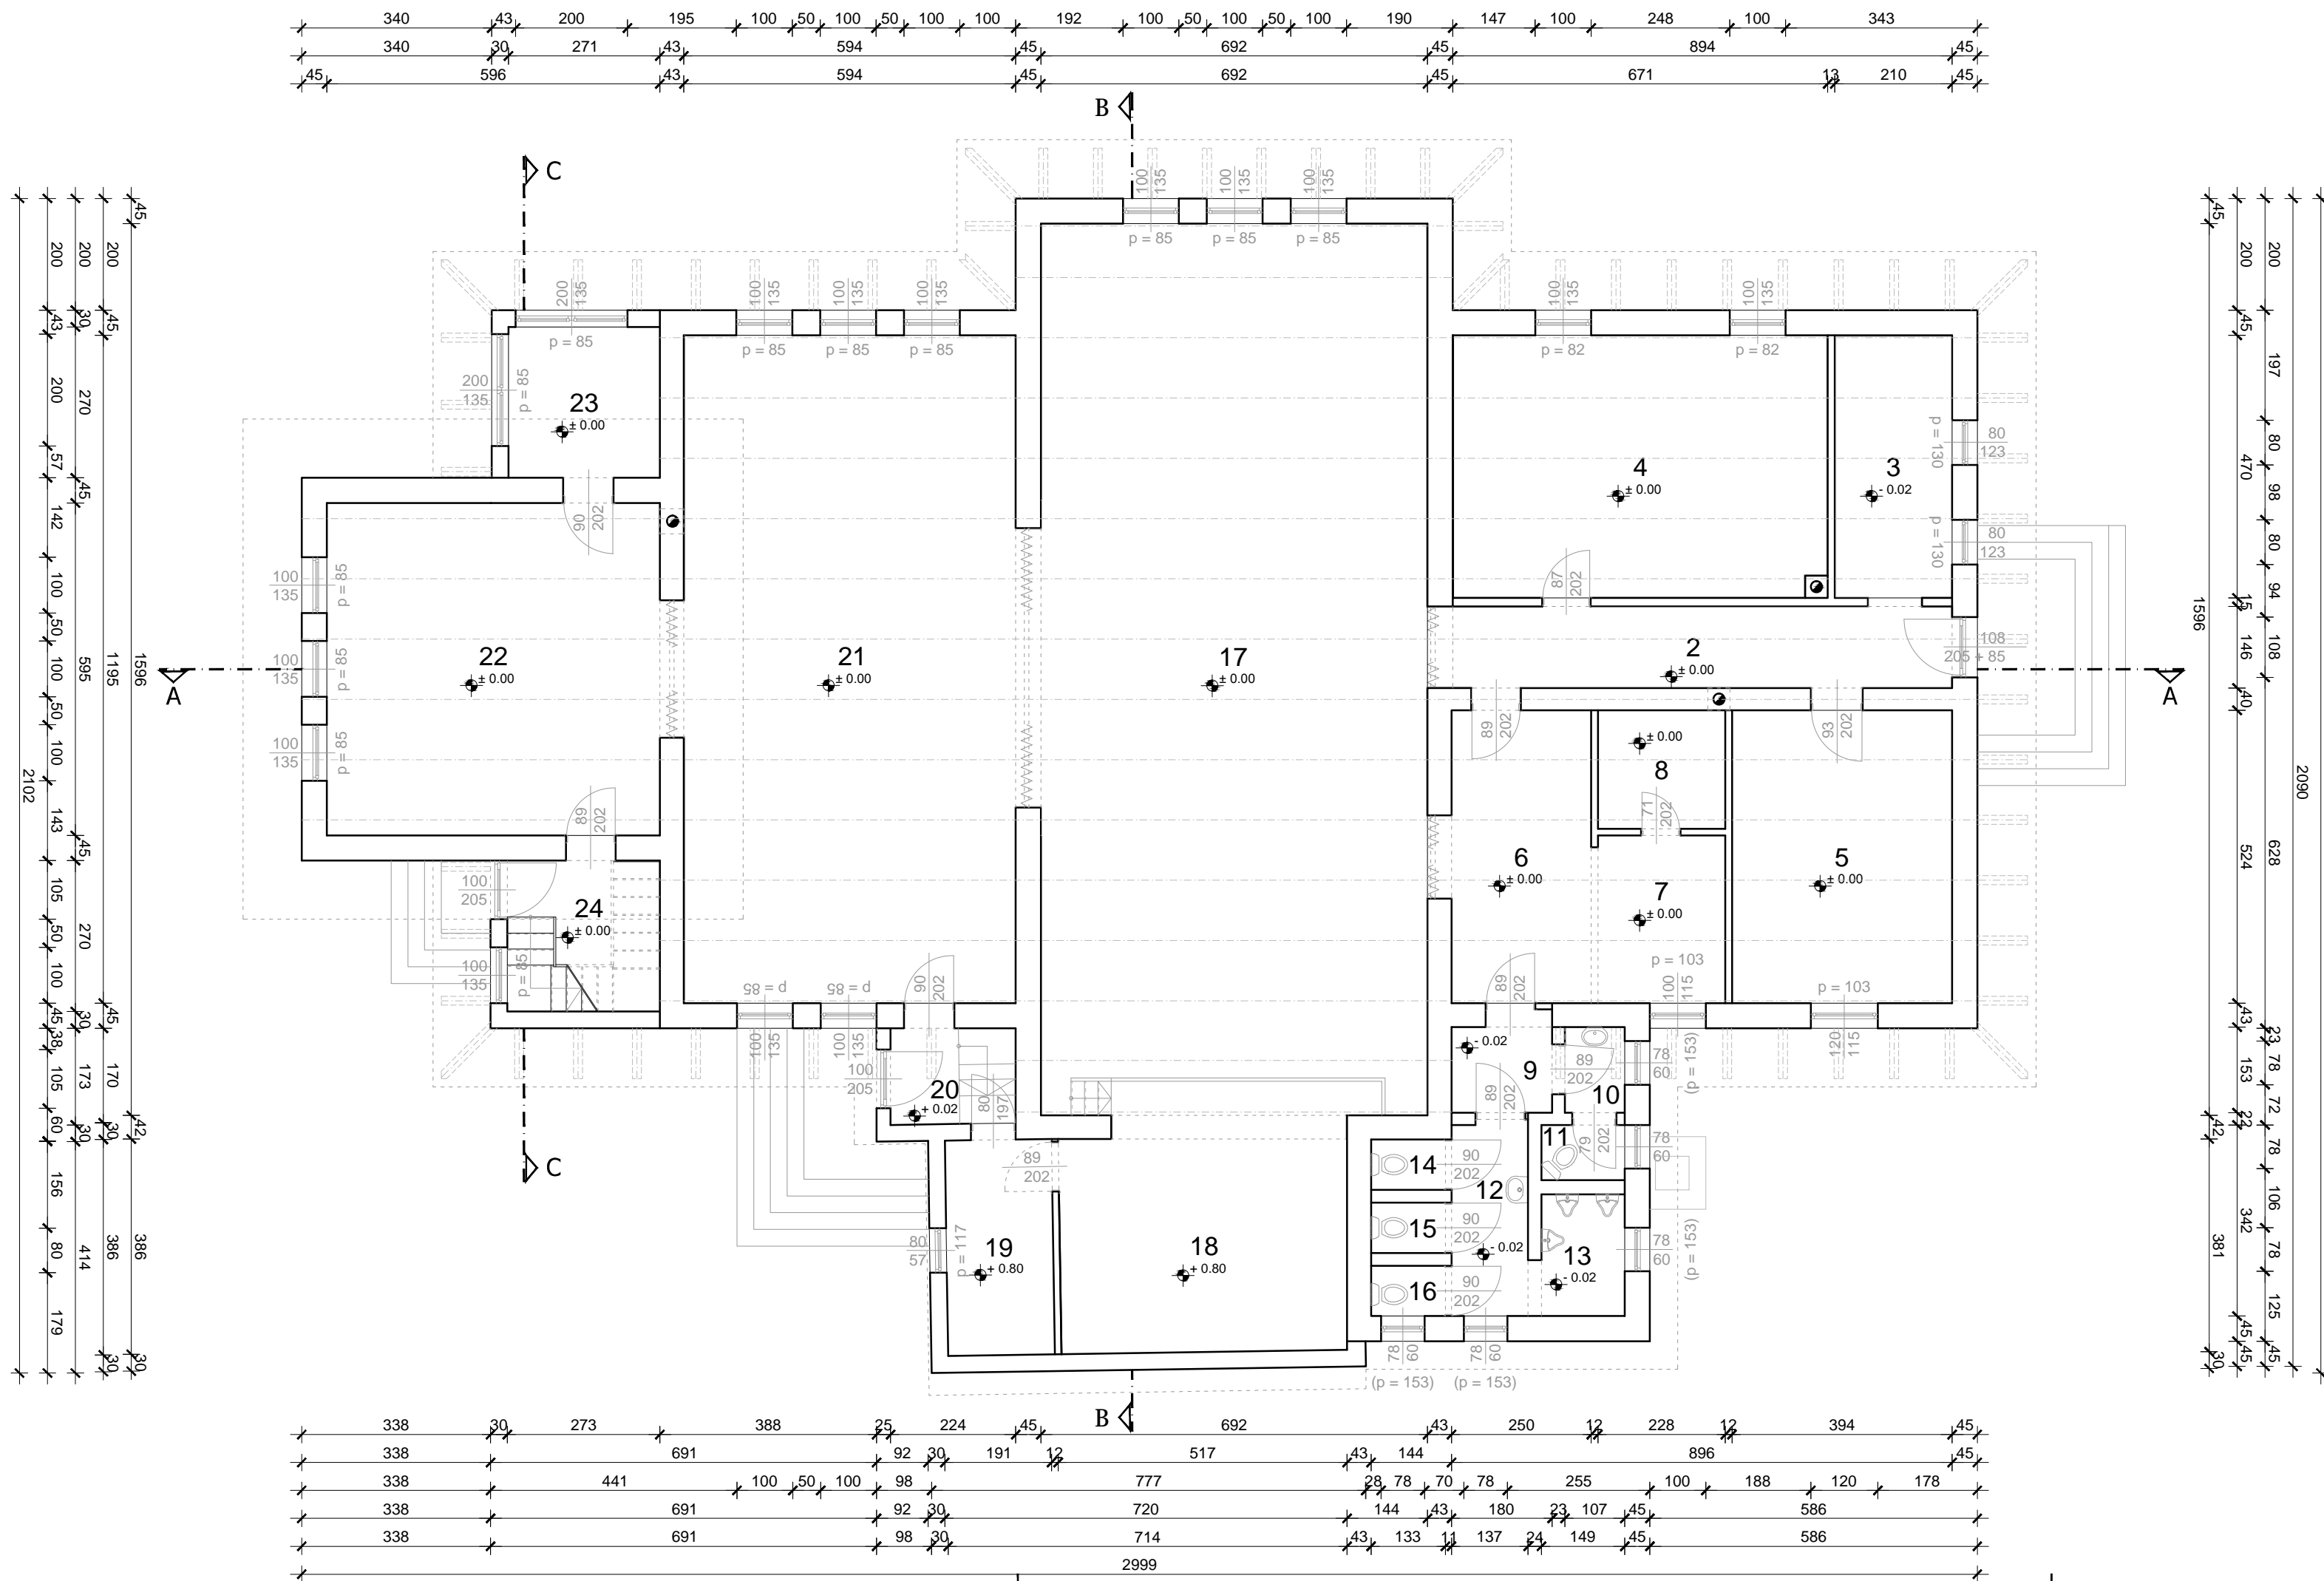

2 - HODNIK	keramičke pločice	P = 13,11 m <sup>2</sup>
3 - PROSTORIJA 1	parket	P = 9,60 m <sup>2</sup>
4 - PROSTORIJA 2	parket	P = 31,06 m <sup>2</sup>
5 - PROSTORIJA 3	parket	P = 20,65 m <sup>2</sup>
6 - PREDPROSTOR	keramičke pločice	P = 13,10 m <sup>2</sup>
7 - KUHINJA	keramičke pločice	P = 7,18 m <sup>2</sup>
8 - SPREMIŠTE	keramičke pločice	P = 4,83 m <sup>2</sup>
9 - PREDPROSTOR	keramičke pločice	P = 3,14 m <sup>2</sup>
10 - WC_a	keramičke pločice	P = 1,64 m <sup>2</sup>
11 - WC_b	keramičke pločice	P = 1,48 m <sup>2</sup>
12 - PREDPROSTOR	keramičke pločice	P = 5,02 m <sup>2</sup>
13 - PISOAR	keramičke pločice	P = 3,25 m <sup>2</sup>
14 - WC	keramičke pločice	P = 1,30 m <sup>2</sup>
15 - WC	keramičke pločice	P = 1,30 m <sup>2</sup>
16 - WC	keramičke pločice	P = 1,30 m <sup>2</sup>
17 - DVORANA 1	parket	P = 110,13 m <sup>2</sup>
18 - BINA	parket	P = 21,36 m <sup>2</sup>
19 - SPREMIŠTE	parket	P = 7,36 m <sup>2</sup>
20 - PREDPROSTOR	keramičke pločice	P = 3,84 m <sup>2</sup>
21 - DVORANA 2	parket	P = 70,75 m <sup>2</sup>
22 - DVORANA 3	parket	P = 35,46 m <sup>2</sup>
23 - PROSTORIJA	parket	P = 7,32 m <sup>2</sup>
24 - STEPENIŠTE	keramičke pločice	P = 7,37 m <sup>2</sup>
<b>PRIZEMLJE NETO UKUPNO</b>		<b>P = 381,55 m<sup>2</sup></b>
