



IZVEDENO STANJE

PRESJEK C-C

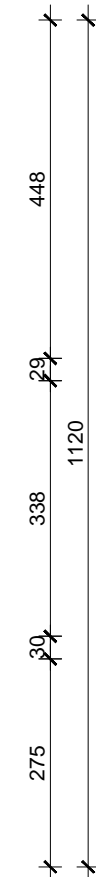

A

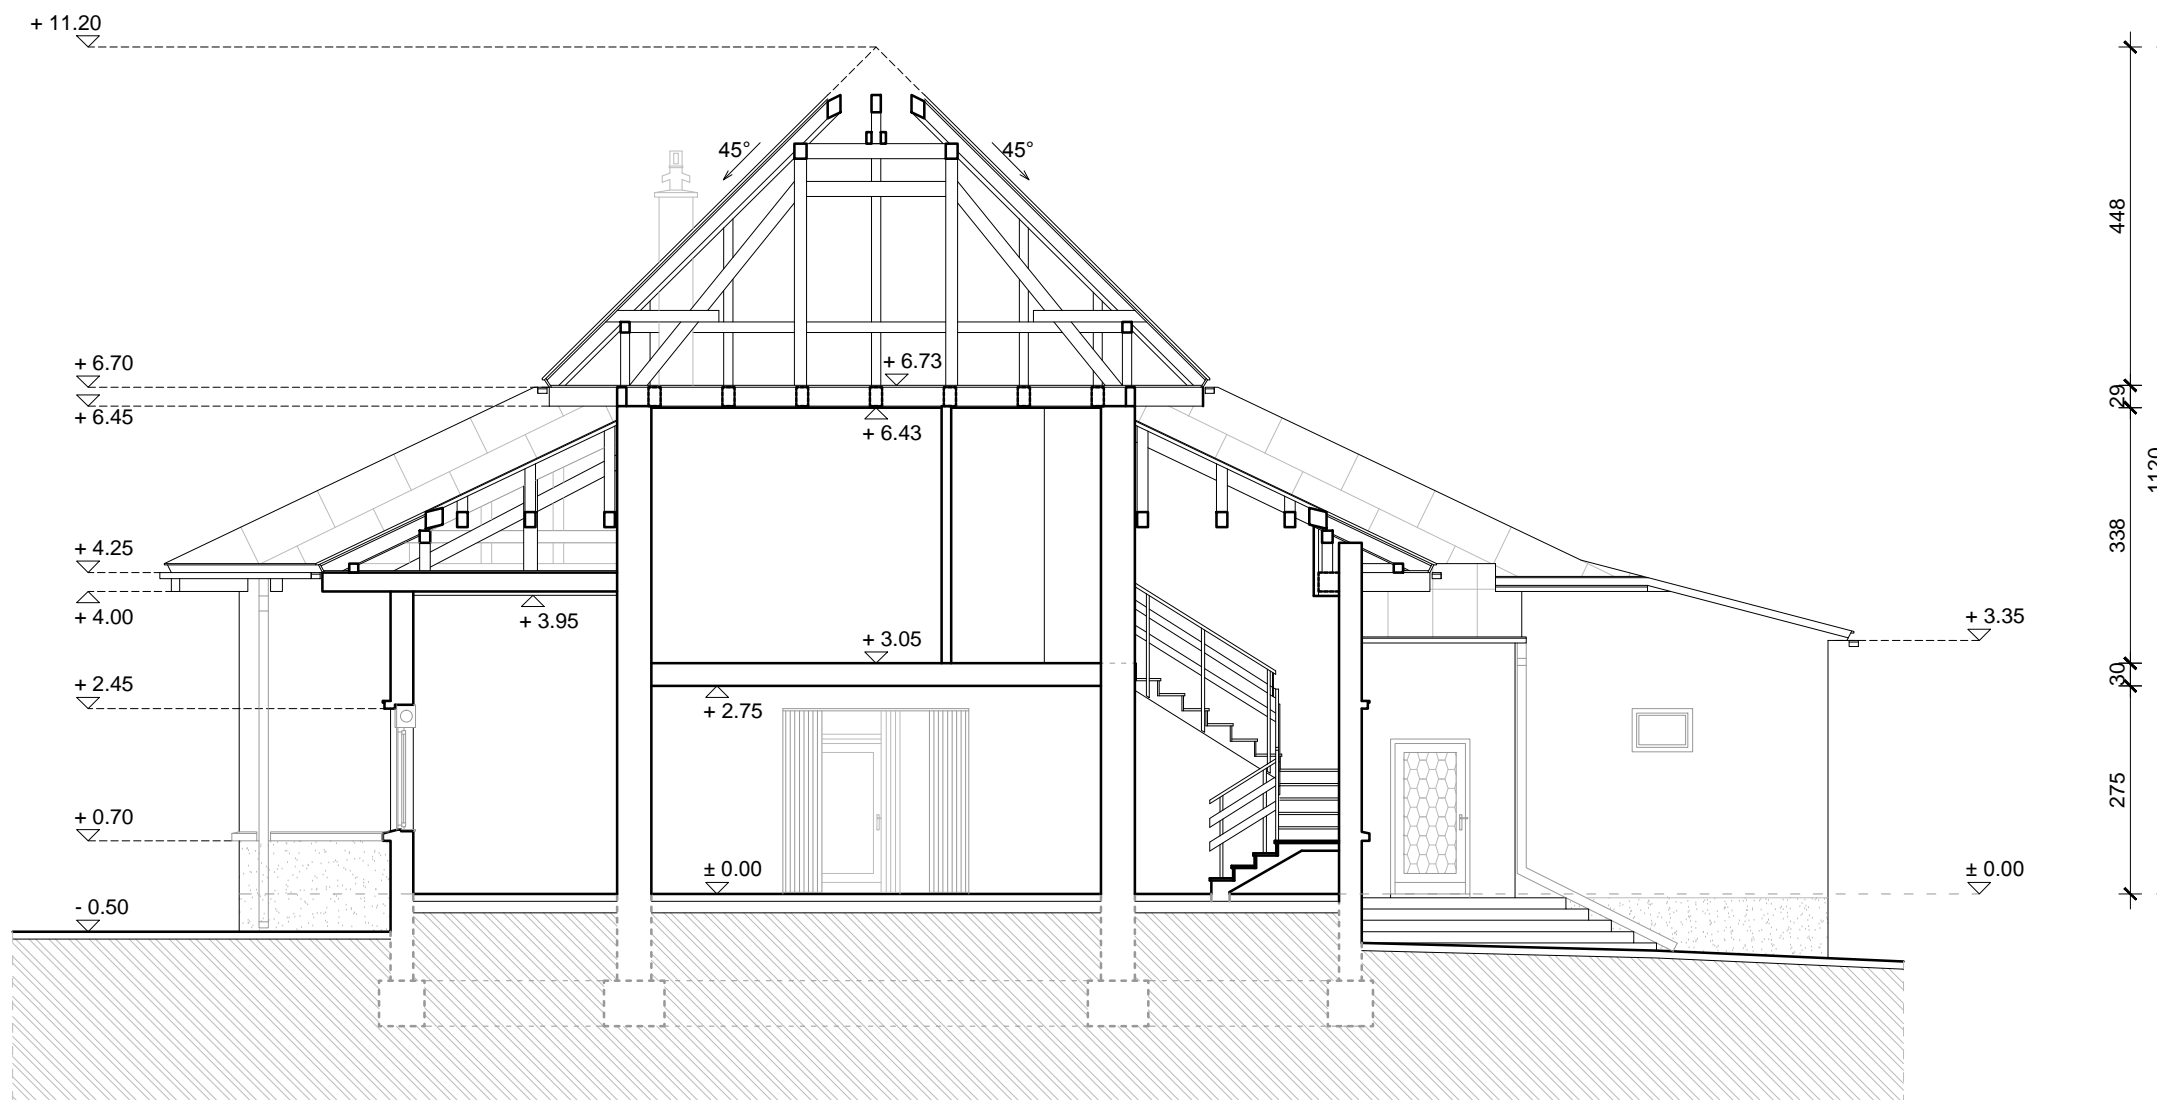